

SURVEY OF PROPERTY

Site of
Town of East Hampton
Suffolk County, New York

SCALE: 1" = 50'


AREA: 57,057 sq. ft.
or 1.3098 acre

SCTM No. 300-189-4-28

TIES TO SEPTIC SYSTEM
(MAIN HOUSE)

ST	A	B
1	21.9'	25.2'
2	44.5'	35.3'
3	40.5'	34.4'

521 p68

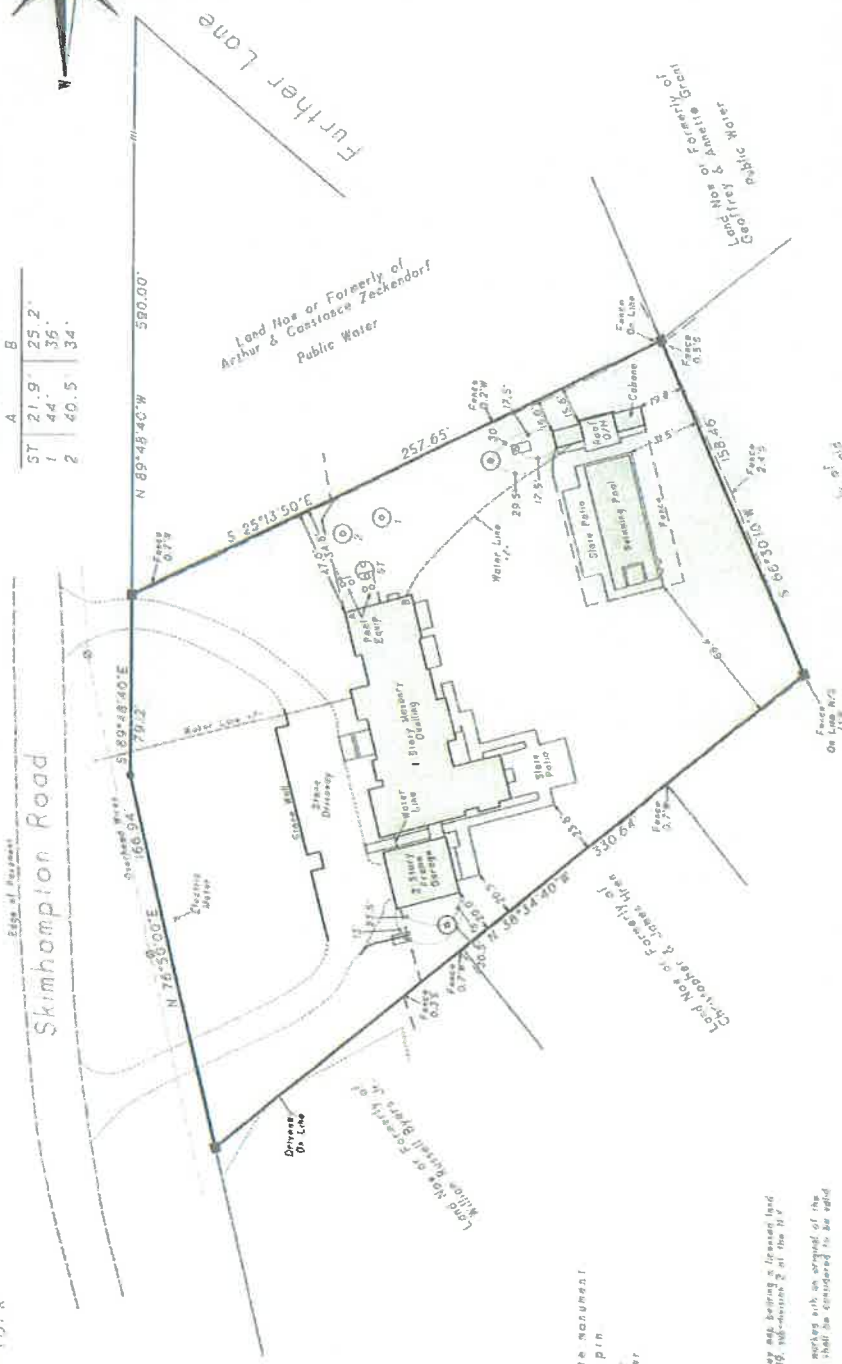

Certified only to:
Kyle Dupre

- ▲ indicates set stake
- indicates found concrete monument
- indicates 1/2" iron pin
- indicates utility pole
- ⊙ indicates concrete cover

NOTES

1. Impoverished alteration or addition to a survey map bearing a license and State Education Law.
2. Only survey from the original of this survey markers with an original of the State Education Law.
3. Certifications indicated herein specify that the survey was prepared in accordance with the existing Code of Practice for Land Surveys adopted by the N.Y. State Association of Professional Land Surveyors' Seal certification, and that the survey was prepared in accordance with the Code of Practice for Land Surveys adopted by the N.Y. State Association of Professional Land Surveyors' Seal certification, and that the survey was prepared in accordance with the Code of Practice for Land Surveys adopted by the N.Y. State Association of Professional Land Surveyors' Seal certification.
4. Underlines improvements or attachments, if any, are not shown herein.
5. The existence of signs of signs, set-backs and/or easements of record, if any, are shown on the plan.
6. All copies of this plan, when on file, shall be retained in full, in accordance with the provisions of the State Education Law, and the appropriate regulatory agency.
7. Elevation shown are based on National Mean Sea Level.
8. Elevation shown herein are for purposes of compliance with the requirements of the Suffolk County Department of Health Services and should not be used for any other purposes.

Not a valid copy unless marked with original lead surveyor's submitted seal & signature

Lot 5 & Christine Walker
ALSO Public Water

Lot 5 of Formerly of
George Walker &
George Walker & Christine Walker

Surveyed: February 16, 2007
David L. Siskos
N.Y.S. Lic. No. 049960

Surveying Company, P.C.
724 Cedar Street
East Hampton, New York 11937
Tel: 631-325-6917 FAX: 631-325-4766